

OWNER:  
Mr. Chertif Medowar

CONSULTANTS

Arch. Roberto Lugo Escamez  
1975-1980-1985-1990-1995-2000-2005-2010-2015-2020

PROJECT:

# #315 Fortaleza, Old San Juan

As Built Drawings  
San Juan, P.R.

NO.	DATE	REVISIONS
1		
2		
3		
4		
5		


NOTES / PERMITS

DATE: July 14, 2019

1st. Fl. Plan, &  
Reflected  
Ceiling


HOTAS

# AB-1

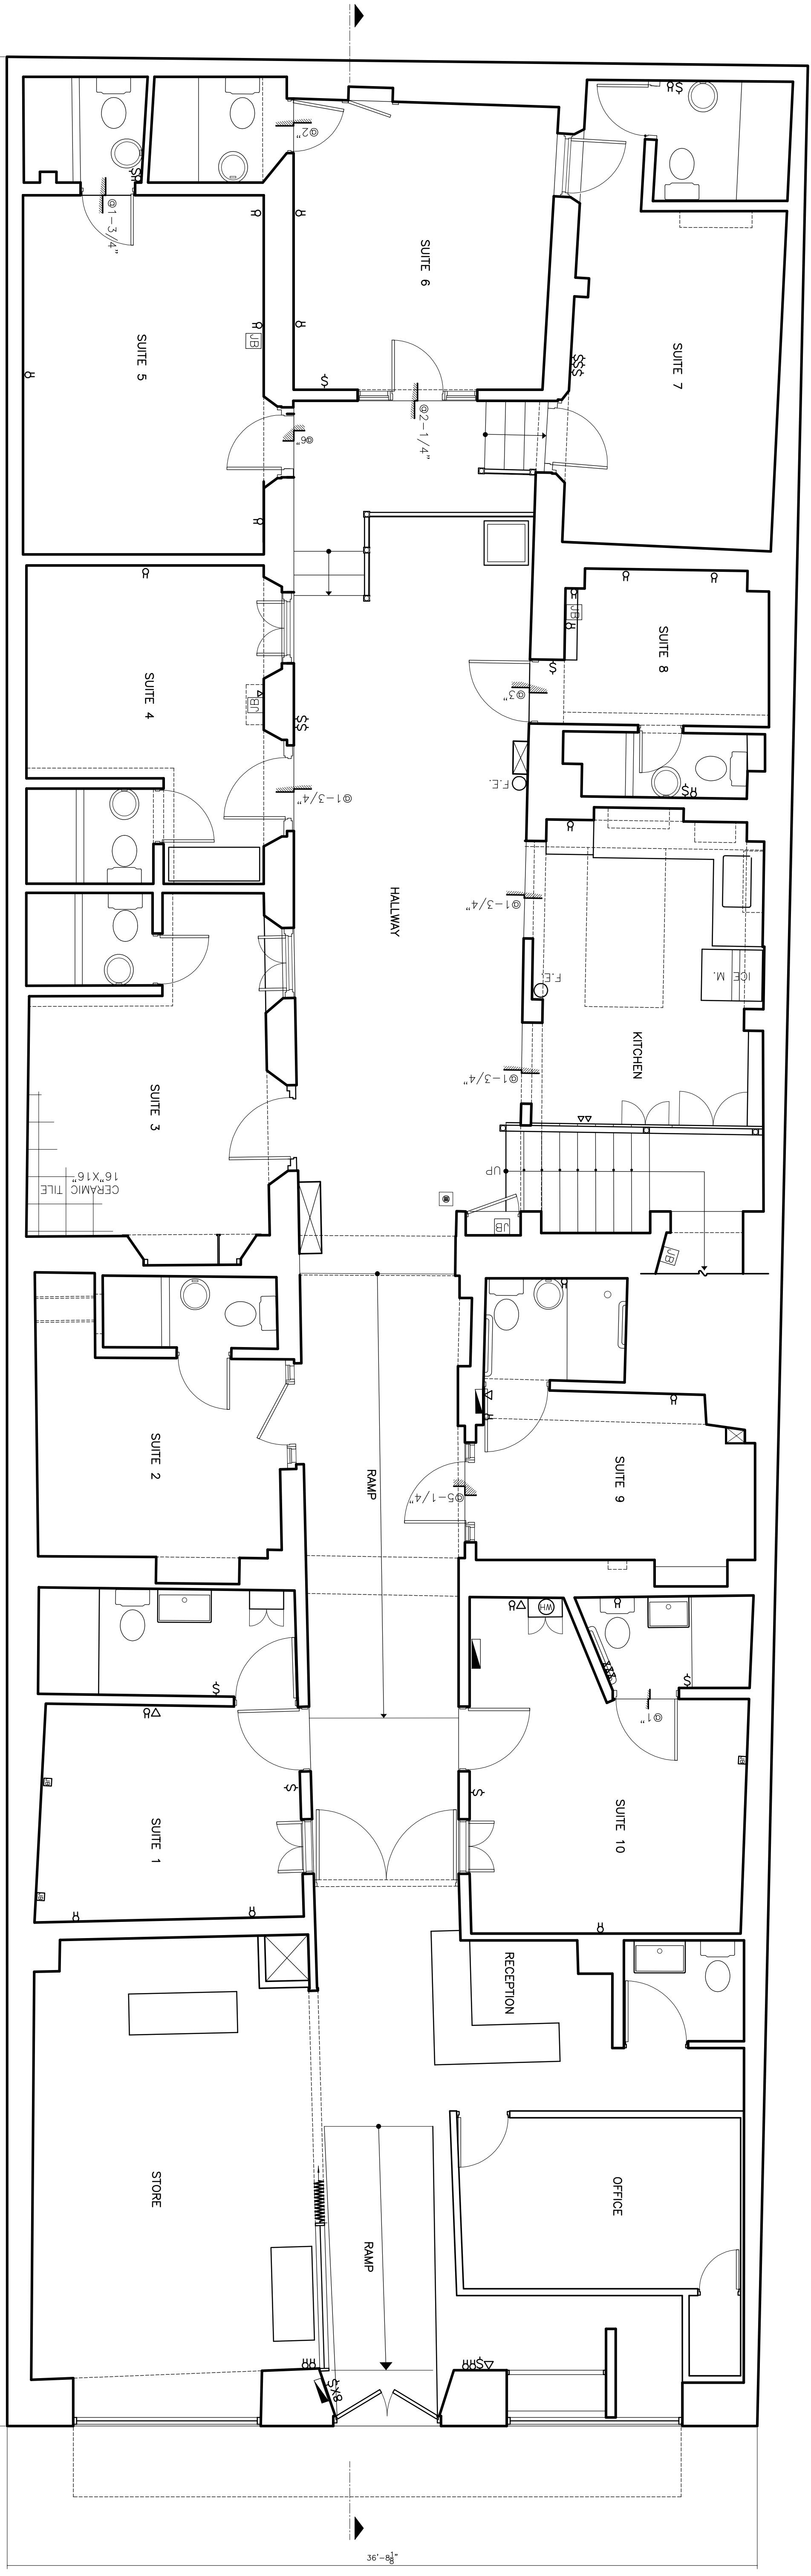

First Floor Plan

Scale: 1/4"=1'-0"  
Net Area: 3,968 SF  
Gross Area: 4,381 SF

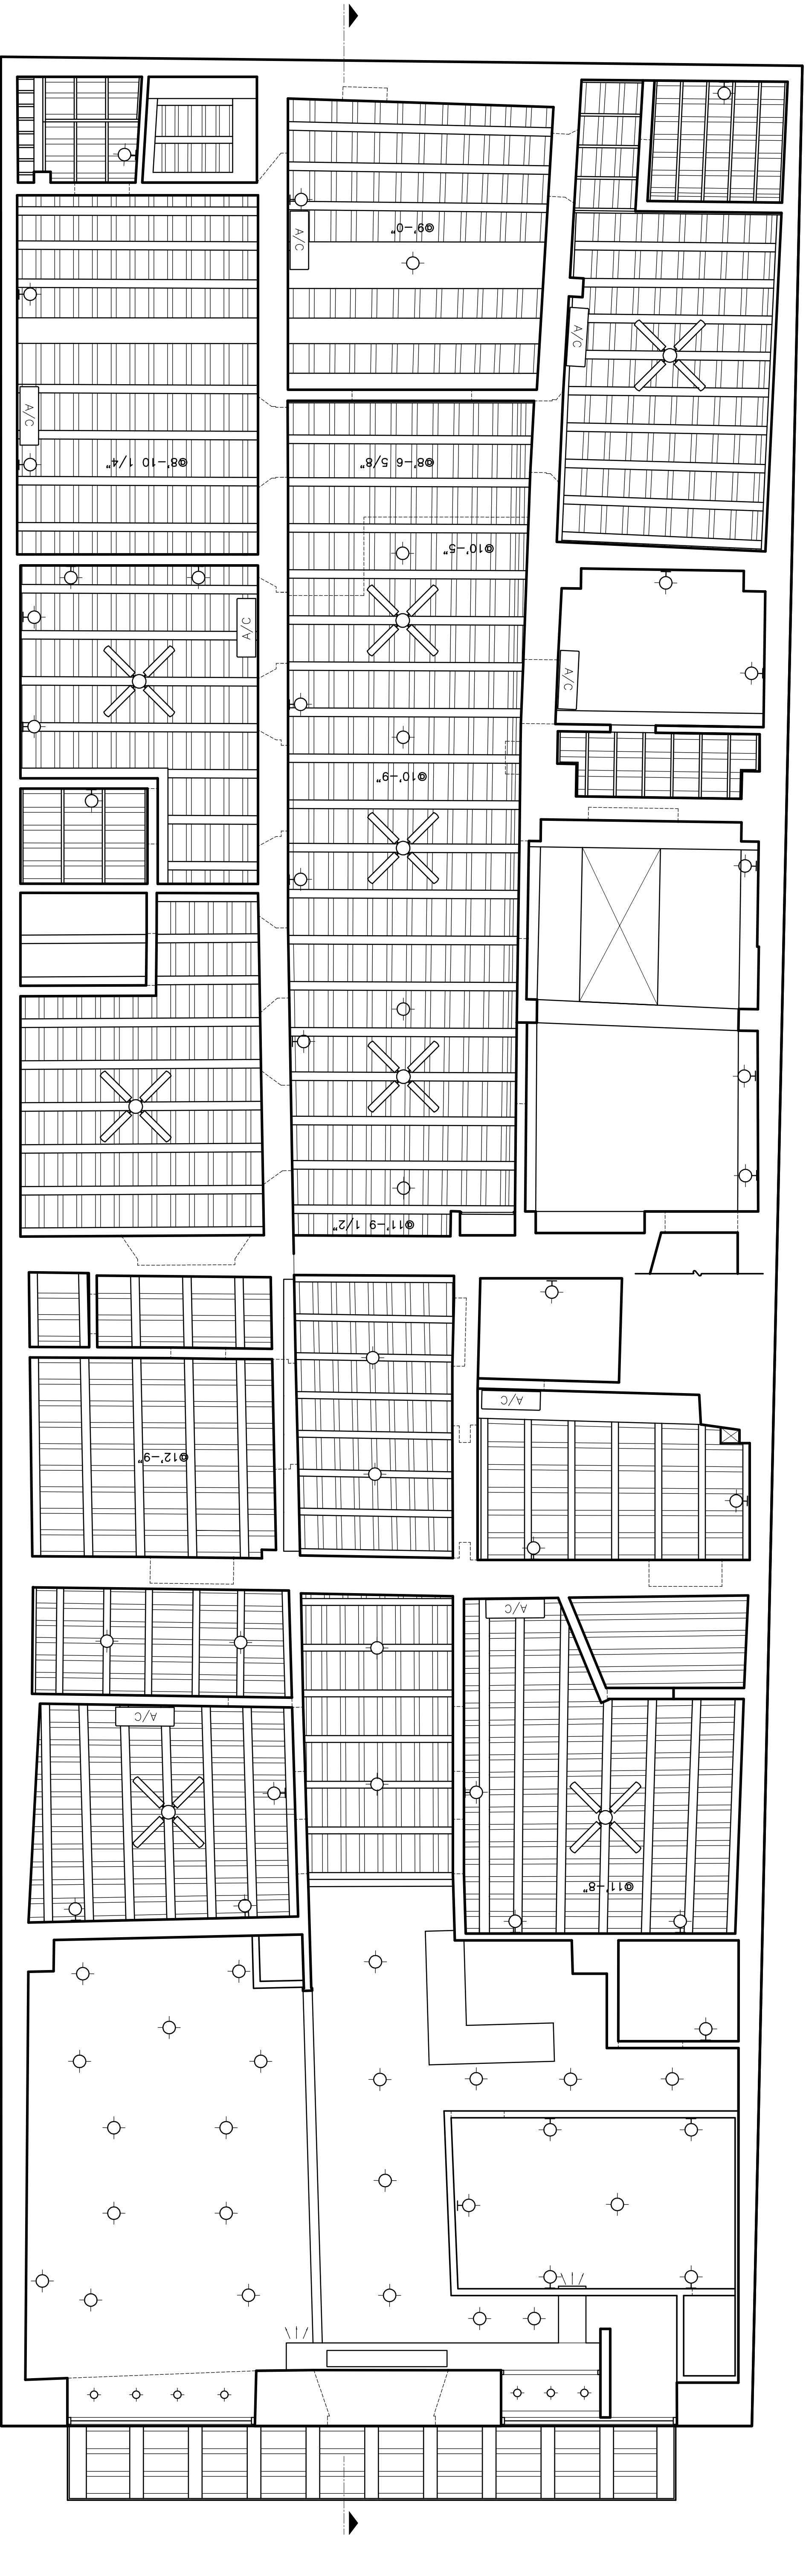

Roof Floor Reflected Ceiling Plan

Scale: 1/4"=1'-0"