


Roof Plan

Scale: 1/4"=1'-0"

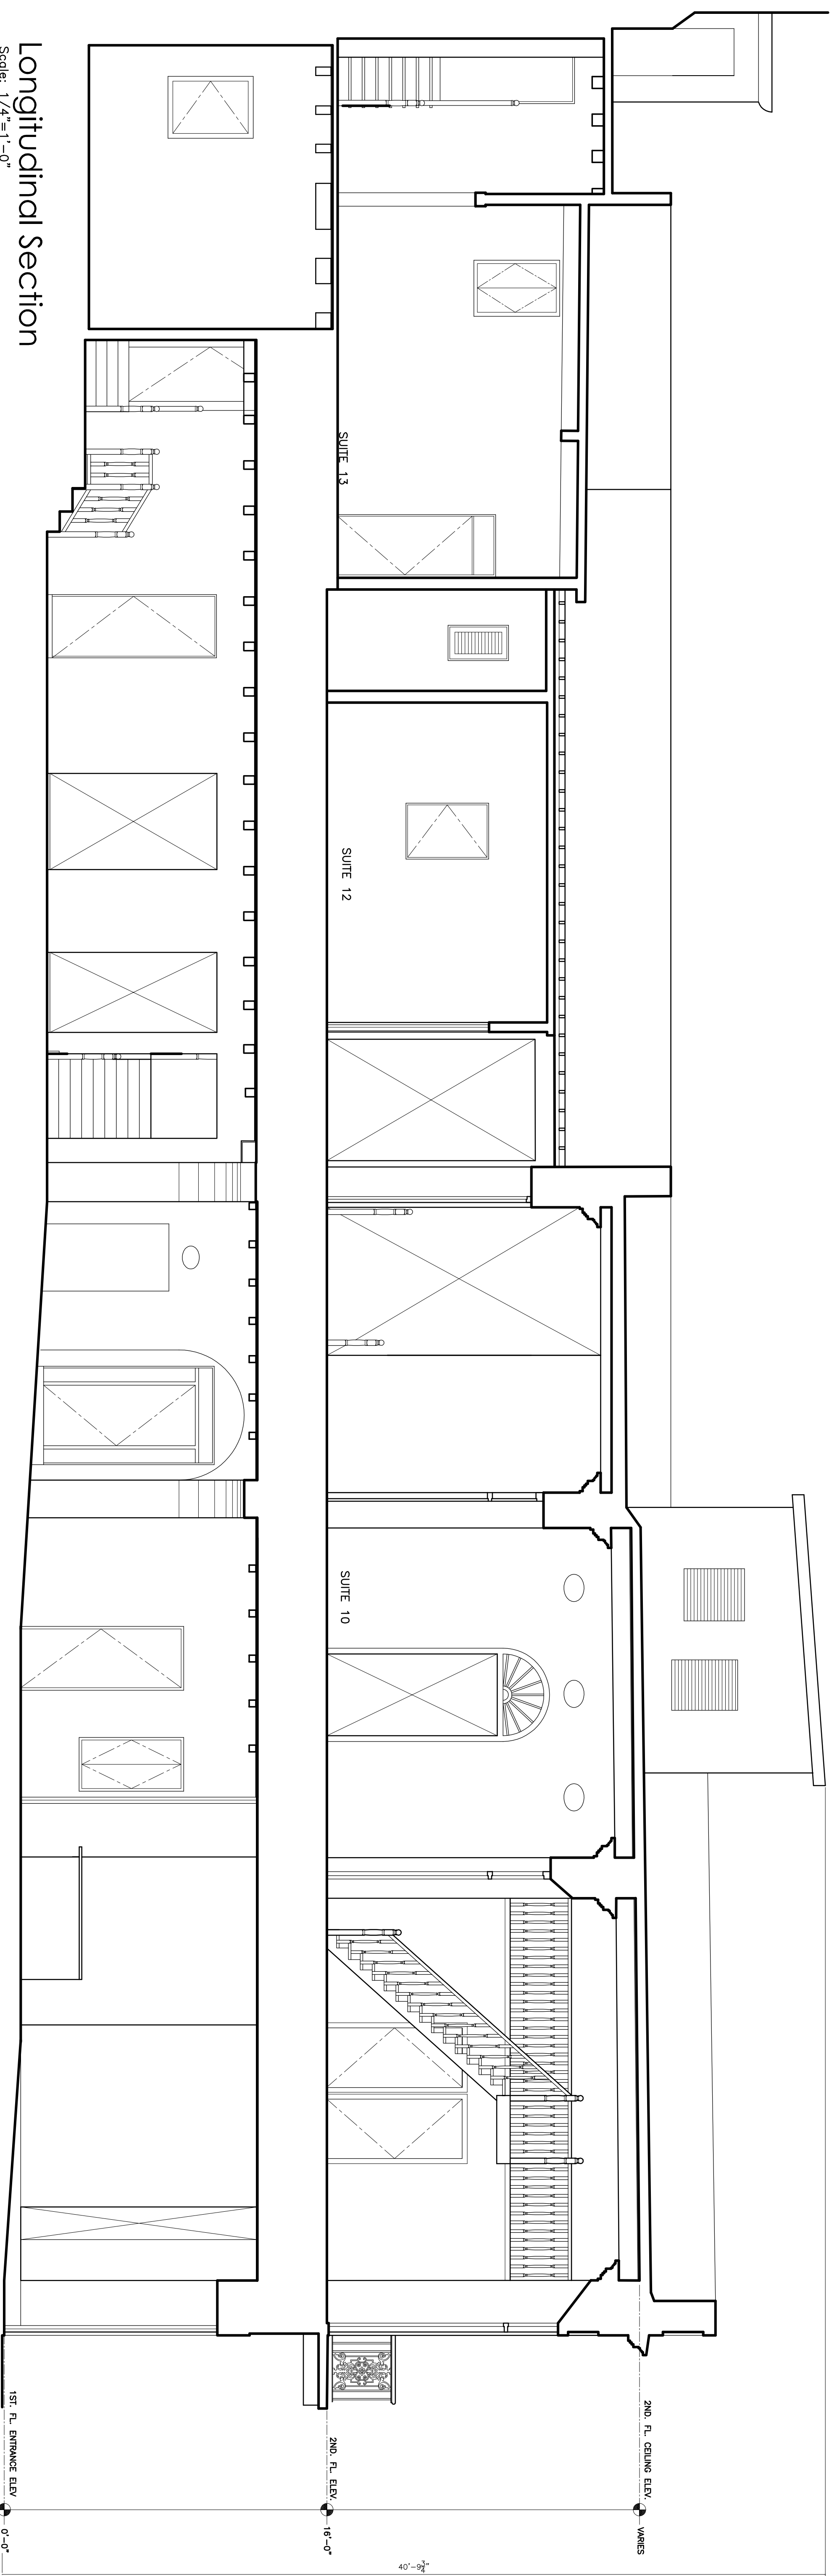

Longitudinal Section

Scale: 1/4"=1'-0"

OWNER:
Mr. Chertif Meddwar

CONSULTANTS

Arq. Robinson Lugo Esquivel
(787) 326-0777 / roblugo@arq.com

PROJECT:

#315 Fortaleza, Old San Juan
As Built Drawings
San Juan, P.R.

REVISIONS

NO.	DATE
1	
2	
3	
4	
5	

NOTES / PERMITS

DATE: July 14, 2019

**Roof Plan &
Longitudinal
Section**

H01A1

AB-3